

Sir,


Lee and Freddie Prouty are requesting a zoning ruling to place a mobile home behind my Mother-In-Laws home at 1714 Barnes Road on 2.54 acres. We have submitted for the installing of 2 septic systems to the Health Department. Before they can accept the septic tank for the mobile home, we have to install one for my Mother-In-Law. This installation has been delayed due to the rain, it was scheduled for 13 April 2015. My Mother-In-Law is in bad health due to two recent back surgeries and being legally blind. She also requires someone to cook and clean her house and give her daily and nightly medications. We are trying to move onto our property to take care of my wife's mother, Dorothy Lawrence. The Health Department will not release us to get water and electricity for the mobile home until we received a zoning ruling.

I have included the Benchmarks for both the homes and septic treatment plants. The health department recommendation for the septic system for my mother-in-law's home is also included.

Ben Prouty  
Freddie Prouty  
601-855-7956

PLAT OF SURVEY  
**PROUTY PROPERTY-FINAL PLACEMENT**  
 SITUATED IN THE NW 1/4 OF THE SW 1/4 AND THE SW 1/4 OF THE NW 1/4 OF SECTION 27 AND  
 THE SE 1/4 OF THE NE 1/4 OF SECTION 28, T9N, R4E, MADISON COUNTY, MISSISSIPPI

I certify that the information on this plat is thorough and accurate to the best of my knowledge.

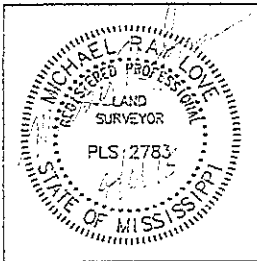

Boundary Line Table		
Line	Bearing	Distance
L1	S 65°47' E	2.70'
L2	N 60°29' E	14.90'
L3	N 66°10'27" E	66.69' (A.P.S.)
L3	N 70°03' E	67.00' (A.P.R.)



SCALE: 1"=100'

DATE OF FIELD SURVEY: 3-04-15

S.I.P. = SET 1/2" x 12" IRON PIN

DEED BOOK 2116, PAGES 921-926

BEARINGS SHOWN HEREON ARE DERIVED FROM PERFORMING GPS OBSERVATIONS AND BASED UPON THE NORTH AMERICAN DATUM 1983 (NAD83), MISSISSIPPI STATE PLANE, GRID COORDINATE SYSTEM, WEST ZONE. CONVERGENCE ANGLE 00°14'30.90993" SCALE FACTOR 0.999971910 COMBINED FACTOR 0.999976145

**CLASSIFICATION:**

THIS SURVEY MEETS THE REQUIREMENTS OF THE STANDARDS OF PRACTICE FOR SURVEYING IN MISSISSIPPI FOR CLASS B SURVEYS AS ADOPTED BY THE MISSISSIPPI BOARD OF LICENSURE FOR PROFESSIONAL ENGINEERS AND SURVEYORS.


**FLOOD NOTE:**

THIS PARCEL IS LOCATED IN FLOOD ZONE X (NOT SHADED) ACCORDING TO FLOOD INSURANCE RATE MAP NO. 28089CC435F, COMMUNITY PANEL NO. 280228 0435 F, EFFECTIVE DATE: MARCH 17, 2010.

THIS PROPERTY MAY BE SUBJECT TO RECORDED, UNRECORDED, OR MISINDEXED INSTRUMENTS WHICH WOULD BE DISCLOSED BY A TITLE EXAMINATION OF SAID PROPERTY.

DATE:	3-04-15	DWG. NO.:	B-464-SURVEY
DRAWN:	RTS/DAC	PROJ. NO.:	B-464
CHECKED:	MRL	CREW:	WILSON

REVISED: MARCH 10, 2015 -BOUNDARY REVISED.  
 APRIL 7, 2015-ADDED NEW MANUFACTURED HOME, METER POLE AND SEWER PLANT.

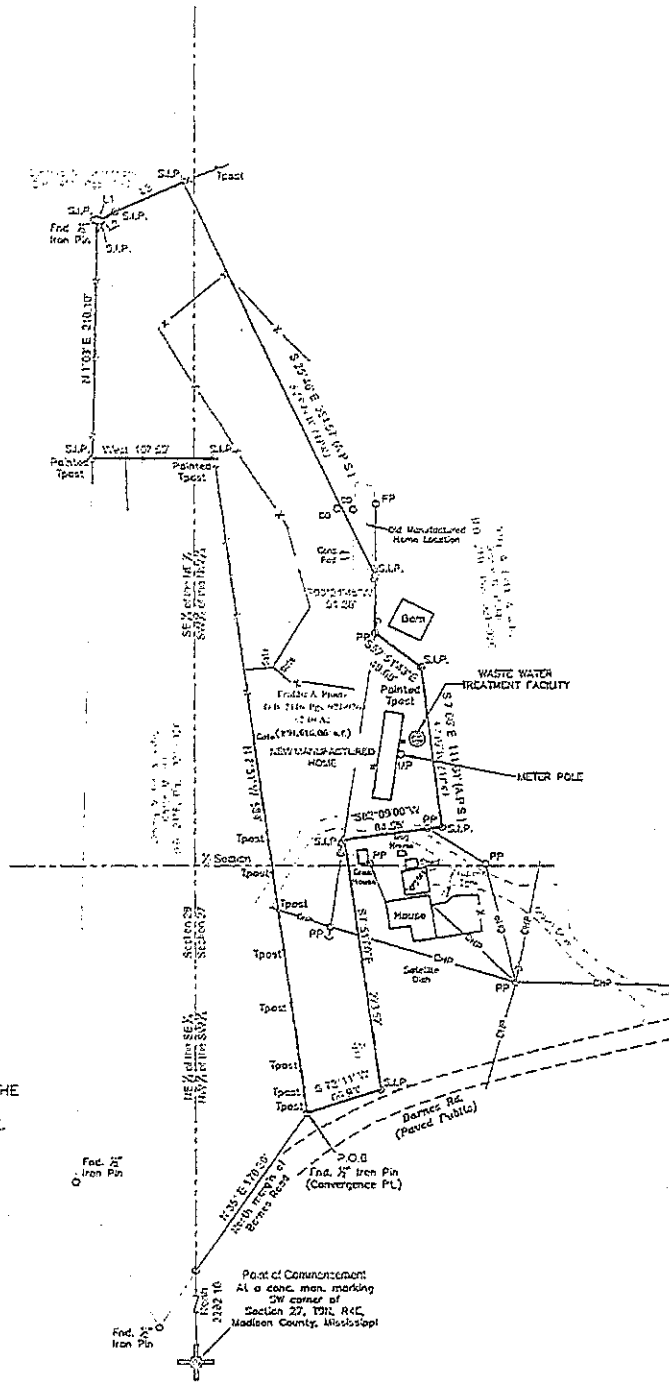

**BENCHMARK SURVEYING, INC.**  
 101 Highpointe Court, Suite 6, Brandon, Mississippi 39042  
 Office: 601-551-1077 Fax: 601-551-0711  
 E-mail: mlove@benchmarkms.net

# Permit/Recommendation

This document is proof that a Notice of Intent has been filed as per  
Section 41-67-5, Mississippi Code of 1972, Annotated

The Mississippi State Department of Health has examined the soil and terrain of the property indicated below. The following recommendations are made using soil and site analysis principles and our best efforts. The Mississippi State Department of Health makes no warranty or representation as to any wastewater system installed. Recommendations may be voided if grading or fill changes the soil characteristics or if plat (dwelling or private water well) is changed and/or relocated.

If you have any questions about your Permit/Recommendation, please contact the environmentalist of record. Current Certified Installers can be verified from [www.healthms.com](http://www.healthms.com) or verified by environmentalists at the local health department.

<b>Applicant:</b> Freddie Prouty 1722 Barnes Road Canton MS 39046	<b>Property:</b> 1714 Barnes Rd Canton 39046 Section: Township: Range: Subdivision Name: Lot Number: Lot Size: 110642 Square Feet 2.54 Acres	<b>Soil and Site Evaluation:</b> Slope: 3.00 %      Soil Textures: Top Soil:            Silt Loam Sub Soil:            Silt Loam Seasonal High Water Table: 10 Inches Restriction:        10 Inches Sensitive Waters:    No
--	--	---

<b>Applicant:</b> Type of Dwelling: Residence Estimated Usage: 300 GPD	<b>Water Supplier:</b> Drinking Water: Public	<b>Soil and Site Evaluation:</b> ID: 134778/122237 Date Issued: 2/20/2015 Non-transferrable, valid for one (1) year from date issued. Notice of Intent filed: 2/19/2015
--	--	---

GPD = Gallons Per Day    N/A = Not Available    H = Horizontal    T = Triangular

Treatment:		
Septic Tank (with baffles):      N/A	Septic Tank (without baffles):      N/A	Advanced Treatment System (ATS):      400 GPD

Disposal:		
Maximum Depth:      N/A	Backfill Required :	12 inches minimum above the top of aggregate or product

Aggregate (Gravel/Tire Chips) Options		
Trench (2 ft wide)      N/A	Trench (3 ft wide)      N/A	Absorption Bed      N/A

Aggregate Replacement Options						
Large Diameter Pipe			Chambers			
Double 6 inch		N/A	Class I	N/A	Class II	N/A
8 inch		N/A	Class III	N/A	Class IV	N/A
10 inch		N/A				

Expanded Polystyrene System (EPS)			Multi-Pipe System (MPS)						
3-8H	Feet	3-10H	Feet	1-12H	Feet	MPS - 9	N/A	MPS 3609	N/A
						MPS - 11	N/A	MPS 3611	N/A
4-9H	Feet	3-10T	Feet	2-12H	Feet	MPS - 13	N/A	MPS 3613	N/A
				3-12H	Feet	MPS - 14	N/A		

ATS Specific Disposal Options				Additional Disposal Options			
Drip Irrigation	500	Feet	Backfill Required	S	Inches	Elevated Sand Mound	
Spray Irrigation	3200	Square feet	Backfill Required		N/A	Basal	N/A
Overland Discharge						Absorption	N/A
1 Point		N/A					
2 Point	0	N/A					
4 Point	0	N/A					

**General Placement/Location of Soil Boring(s):**

**Notes:**

**Author:** Kenneth Evans

**Next Steps:**

Please make several copies of this document (Permit/Recommendation), and supply to the following if applicable:

- \* Public utility supplying water, to receive a water meter
- \* Certified well driller, if water source is from a private well
- \* County Code Office (Planning Department), placement/building permit
- \* Certified Installer, for installation

**REMINDER:** Approval of the design, construction or installation of an Individual On-site Wastewater Disposal System by the Department is required. The Certified Installer is responsible for notifying the Department 24-hours before beginning installation of your Individual On-site Wastewater Disposal System and, at that time, to schedule a time for inspection of the system with the Department.

After the inspection, you must provide the Department with the following:

- \* Affidavit - Installation (From the Certified Installer)
- \* Affidavit - Maintenance (From you, if an Advanced Treatment System was installed)
- \* \$75.00 fee for Final Approval (document)

**REMINDER:** If any person or Certified Installer fails to obtain Final Approval or submit an Affidavit of proper installation to the Department in the installation of the system, the Department, after due notice and hearing, may levy an administrative fine not to exceed \$10,000.00. Also, if any person is operating in the state as an installer without certification by the Department, the Department, after due notice and opportunity for an administrative hearing, may impose a monetary penalty not to exceed \$10,000.00 for each violation as per Section 41-67-7(4) and 41-67-25(8) of the Mississippi Individual On-site Wastewater Disposal System Law.

**Environmentalist Signature:**




**Date:**

2-20-15

# PLAT OF SURVEY PROUTY PROPERTY

SITUATED IN THE NW 1/4 OF THE SW 1/4 AND THE SW 1/4 OF THE NW 1/4 OF SECTION 27 AND  
THE SE 1/4 OF THE NE 1/4 OF SECTION 28, T9N, R4E, MADISON COUNTY, MISSISSIPPI

I certify that the information on this plat is thorough and accurate to the best of my knowledge.

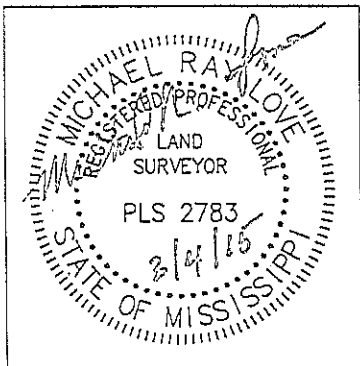

Line	Bearing	Distance
L1	S 65°47' E	2.70'
L2	N 60°29' E	14.90'
L3	N 66°10'27" E	66.69'
L3	N 70°03' E	67.00'

(A.P.S.)  
(A.P.R.)



DATE OF FIELD SURVEY: 3-04-15

S.I.P. = SET 1/2" x 18" IRON PIN

DEED BOOK 2116, PAGES 921-926

BEARINGS SHOWN HEREON ARE DERIVED FROM PERFORMING GPS OBSERVATIONS AND BASED UPON THE NORTH AMERICAN DATUM 1983 (NAD83), MISSISSIPPI STATE PLANE, GRID COORDINATE SYSTEM, WEST ZONE. CONVERGENCE ANGLE 00°14'30.90993" SCALE FACTOR 0.999971910 COMBINED FACTOR 0.999976145


**CLASSIFICATION:**

THIS SURVEY MEETS THE REQUIREMENTS OF THE STANDARDS OF PRACTICE FOR SURVEYING IN MISSISSIPPI FOR CLASS B SURVEYS AS ADOPTED BY THE MISSISSIPPI BOARD OF LICENSURE FOR PROFESSIONAL ENGINEERS AND SURVEYORS.

**FLOOD NOTE:**

THIS PARCEL IS LOCATED IN FLOOD ZONE X (NOT SHADED) ACCORDING TO FLOOD INSURANCE RATE MAP NO. 28089C0435F, COMMUNITY PANEL NO. 280228 0435 F, EFFECTIVE DATE: MARCH 17, 2010.

THIS PROPERTY MAY BE SUBJECT TO RECORDED, UNRECORDED, OR MISINDEXED INSTRUMENTS WHICH WOULD BE DISCLOSED BY A TITLE EXAMINATION OF SAID PROPERTY.

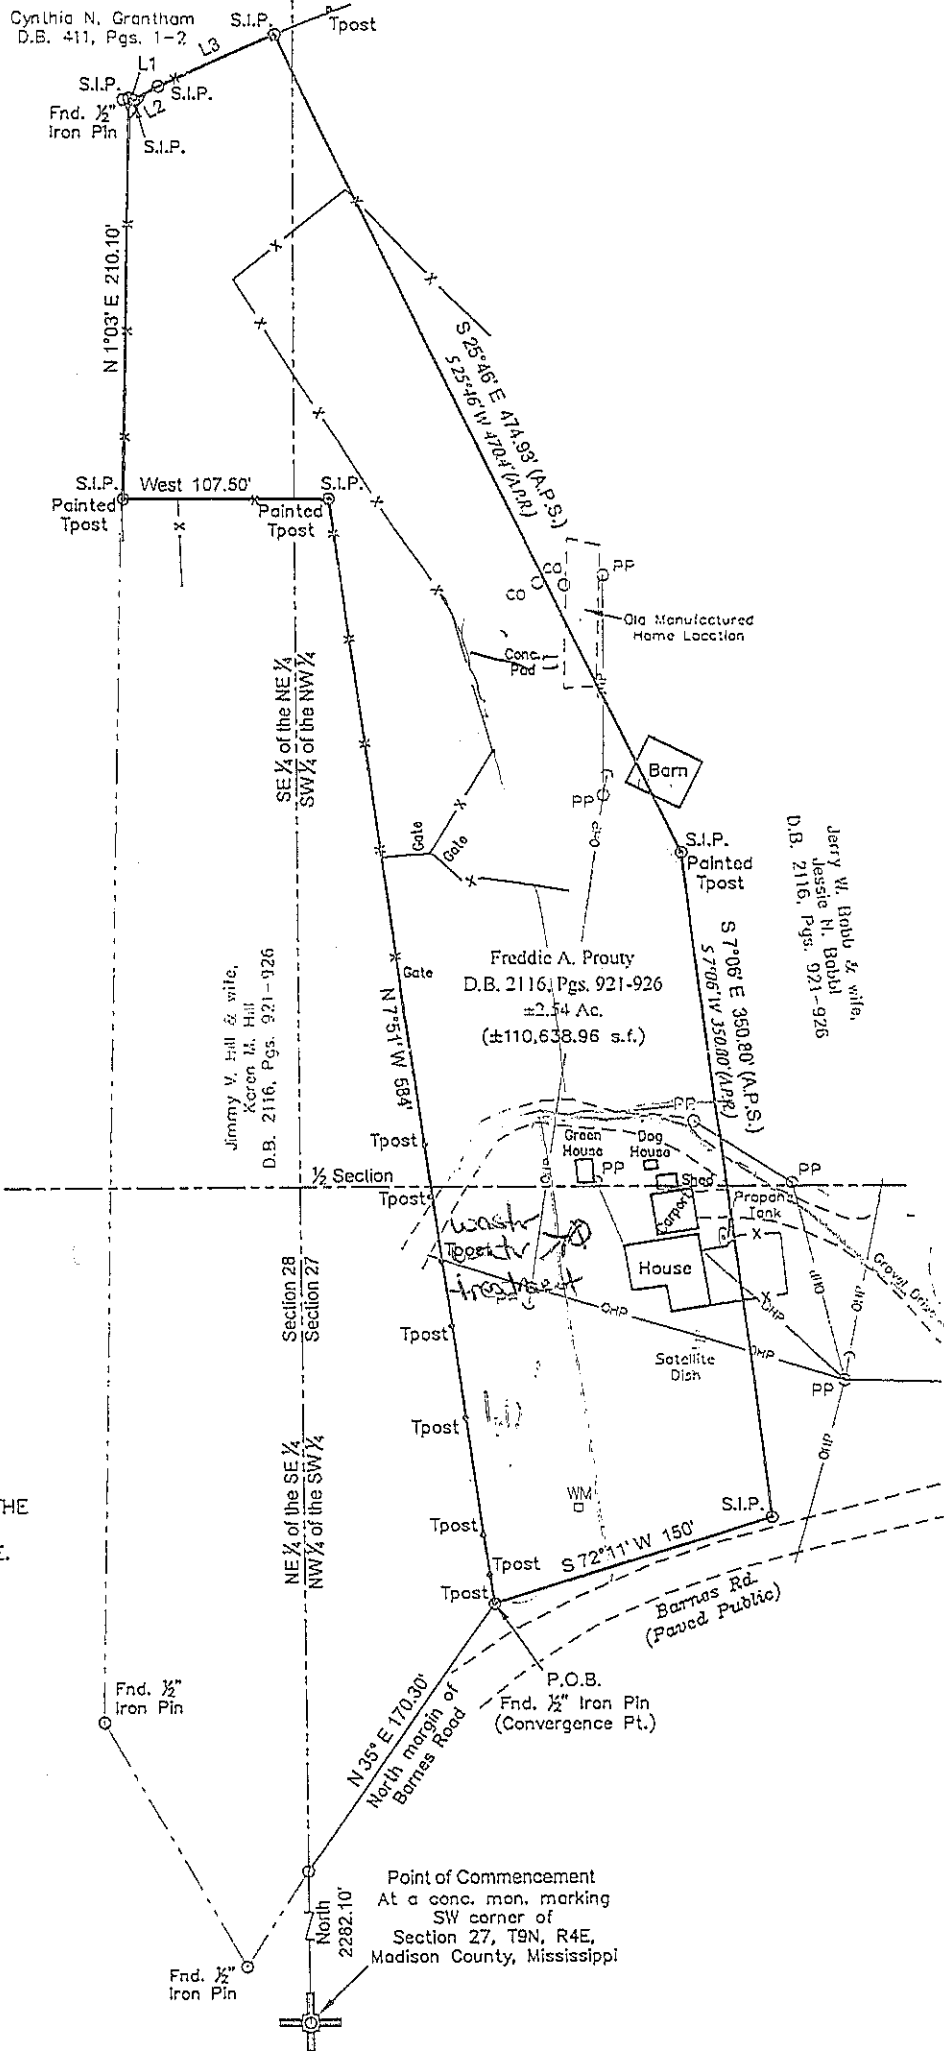

DATE:	3-04-15	DWG. NO:	B-4644
DRAWN:	RTS	PROJ. NO:	B-4644
CHECKED:	MRL	CREW:	WILSON
REVISED:			

## BENCHMARK ENGINEERING & SURVEYING, LLC

101 Highpointe Court, Suite B, Brandon, Mississippi 39042  
Office: 601-591-1077 Fax: 601-591-0711  
E-mail: mlove@benchmarkms.net

